


**CROSS SECTION DETAIL
CONNECTION TO EXISTING
SUMP BOX**
Scale 1 = 1/2

LEGEND

- ⊗ Indicates Gate Valve
- Indicates Manhole With Pressure Lid

NOTE All Pipe Shall Be Type 15 Asbestos Bonded Cement

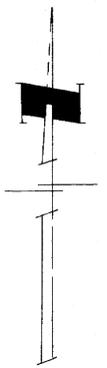

REVISIONS BY DATE DESCR BY DATE DESCR BY DATE DESCR	DATE August, 1971 SCALE 1" = 100'	DRAWN JAL CHECKED JFW APPROVED ERB	PROJECT NO 68 2 617 0130	NELSON - HALEY - PATTERSON AND QUIRK ENGINEERING CONSULTANTS GREELEY - Grand Junction COLORADO	Foresite Park For Industry	IRRIGATION SYSTEM	SHEET 2 SHEETS 1
--	--------------------------------------	--	-----------------------------	--	----------------------------	-------------------	------------------------