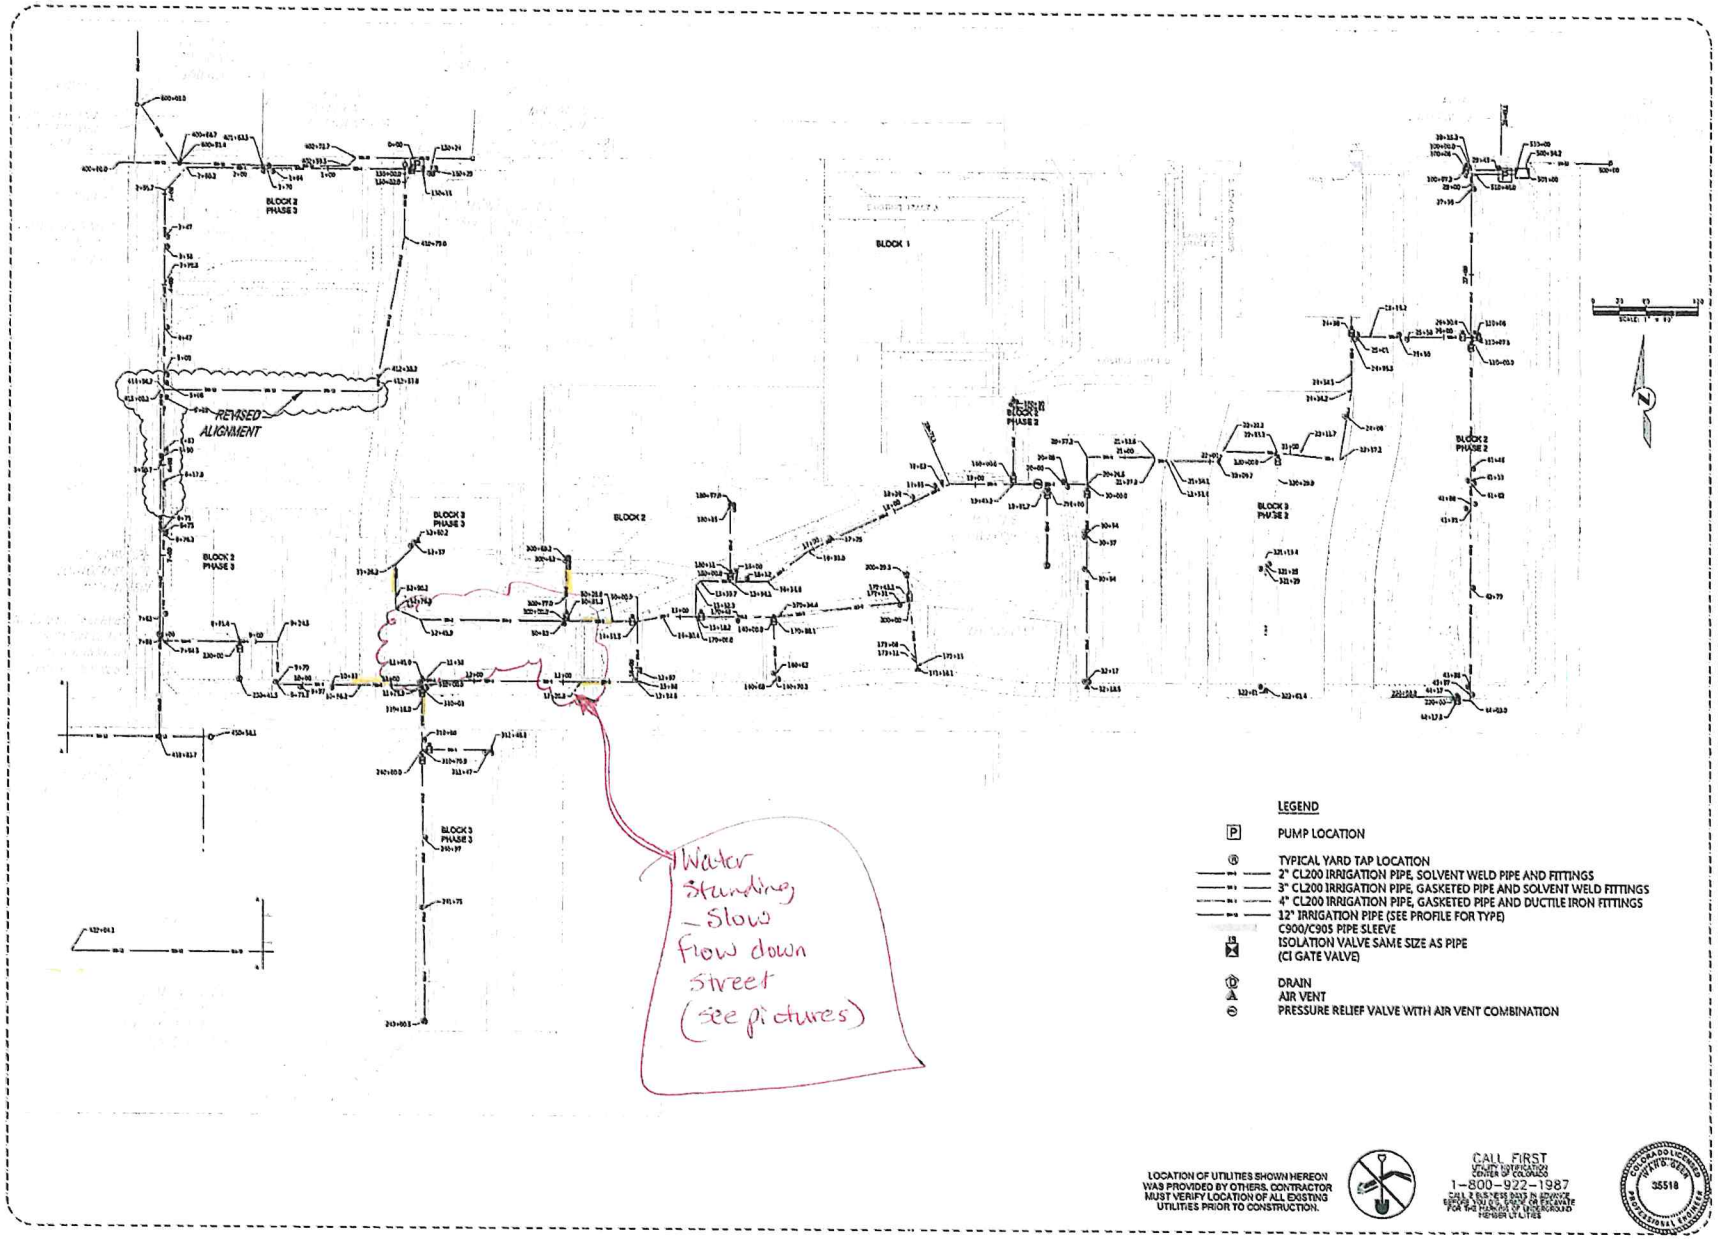

SUNDANCE VILLAGE
PRESSURE IRRIGATION SUPPLY
PLAN VIEW
Grand Junction, Colorado

Title:	
Design By:	CDH
Drawn By:	CDH
Reviewed By:	IDG
Design Date:	9-29-2008
JOB #	08COM056
JOB STATUS:	0 DRAFT 0 PRELIMINARY 0 SUBMITTAL 0 FINAL 0 CONSTRUCTION 0 AS-BUILT
DRAWING NO.	
Scale:	1"=60'-0"
Re-Issue Date:	11-24-2008 3-4-2009
Sheet No.	I-2

Water Engineering
A Division of Grand Junction Pipe & Supply Co.
2564 PATTERSON Road, Suite C
Grand Junction, CO 81506
(970) 241-4722
(970) 241-4182 Fax
Mailing Address:
P.O. Box 1486
Grand Junction, CO 81502

July 2012