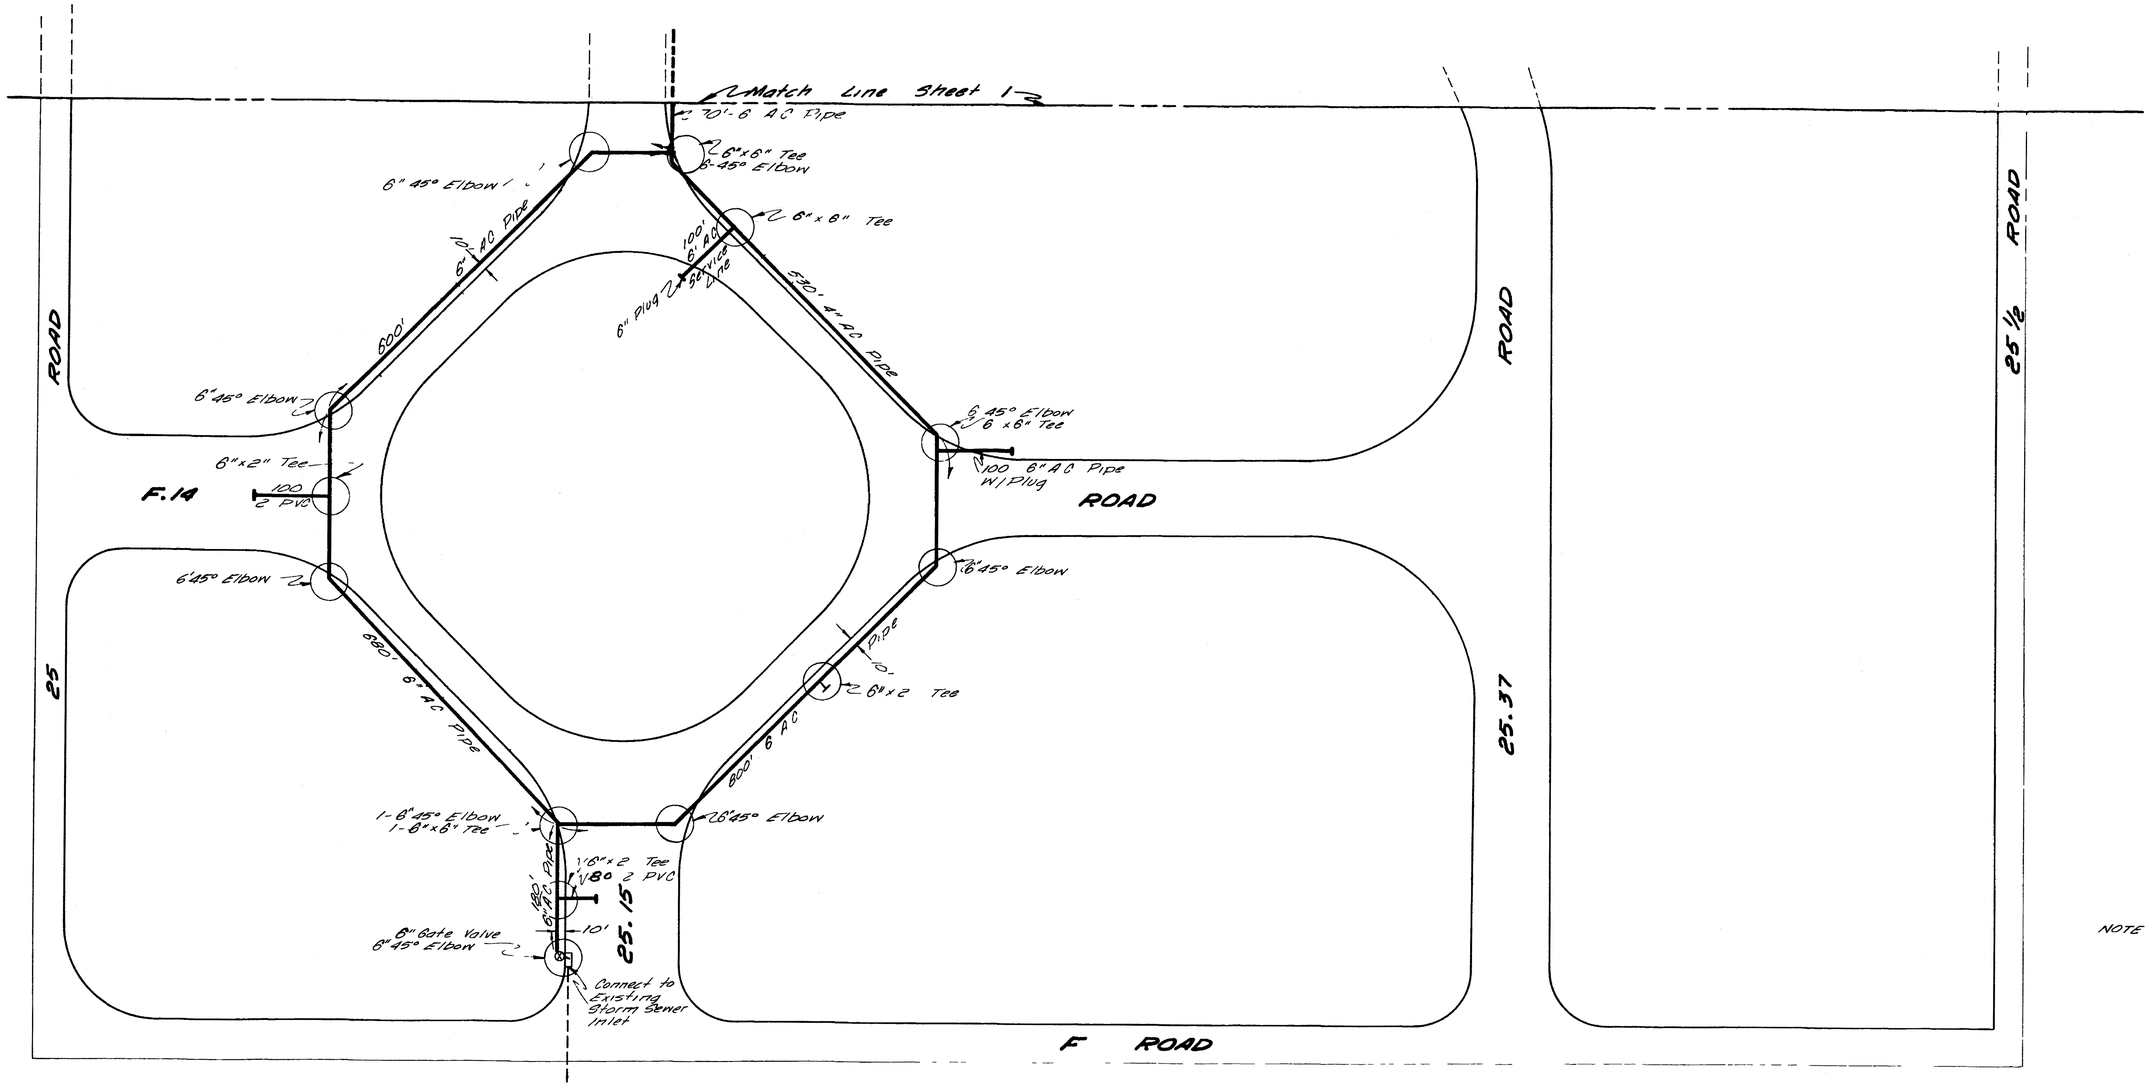

LEGEND

⊗ Indicates Gate Valve

● Indicates Manhole With Pressure Lid

NOTE All Pipe Shall Be Type 15 Asbestos Bonded Cement

REVISIONS							
BY JCG	DATE Nov 22, 1971	DESCR As-Built	DATE August, 1971	DRAWN TAL	PROJECT NO 69 2 BUT 0138	NELSON-HALEY-PATTERSON AND QUIRK ENGINEERING CONSULTANTS GREELEY - Grand Junction COLORADO	Foresite Park for Industry	IRRIGATION SYSTEM	SHEET 2 SHEETS 2
BY	DATE	DESCR	SCALE 1"=100'	CHECKED BFW					
BY	DATE	DESCR		APPROVED ERB					

02095712.tif